Instr. Number: 23-3599 BK: 2023 PG: 3599

Recorded: 8/29/2023 at 9:29:46.0 AM


County Recording Fee: \$7.00 lowa E-Filing Fee: \$3.13 Combined Fee: \$10.13

Revenue Tax:

NAOMI ELLIS, RECORDER Marion County, Iowa

PREPARED BY & RETURN TO TERRY COADY, SNYDER & ASSOCIATES, INC. 2727 SW SNYDER BLVD, ANKENY, IOWA 50023 (515) 964-2020

UNITED STATES PUBLIC LAND SURVEY CORNER CERTIFICATE OF Land Survey Monuments situated in Section 20 21, West of the Fifth Principal Meridian, Previously recorded in Book 1, Page 318 __, Township _ ____MARION MARION County, Iowa in County Recorder's Office. Iowa. (book, page, document number, ect.) (Show reason for preparing this certificate, the evidence and detailed procedures used in establishing the corner positions and monumentation found or placed.) Monument Description and Remarks: THE EXISTING CORNER CERTIFICATE RECORDED IN BOOK 1 PAGE 318 OF THE MARION COUNTY RECORDER'S OFFICE INDICATED THAT THE CENTER OF SECTION IS MONUMENTED WITH A 1/2" REBAR WITH YELLOW PLASTIC CAP #13286. SEARCHED AREA USING EXISTING TIES AND A METAL DETECTOR AND FOUND MONUMENT THAT OF RECORD. THIS CERTIFICATE HAS BEEN PREPARED BECAUSE THERE ARE NO LONGER THREE VALID TIES OF RECORD. Plan-View (Show a minimum of three reference ties to durable physical objects, relevant monuments and physical conditions that will enable recovery of the corner.) CENTER OF SECTION FND 1/2" REBAR YELLOW PLASTIC CAP #13286 6" DEEP 33.40'M 33.4'R FND US ARMY CORPS MONUMENT SET NAIL W/SHINER IN POWER POLE GRAVEL DRIVE 25TH PLACE SET NAIL W/SHINER IN POWER POLE

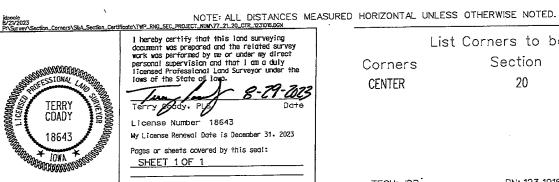

List Corners to be Indexed Section Twp Range Corners 21 77 CENTER 20

DATE: 8-16-23 TECH: JDP PN: 123.1016